MUNICIPALITY OF MONROEVILLE

ALLEGHENY COUNTY, PENNSYLVANIA

ORDINANCE NO. 2230

AN ORDINANCE OF THE MUNICIPALITY OF MONROEVILLE ACCEPTING A DEED OF DEDICATION OF A FIFTY (50) FOOT WIDE RIGHT OF WAY KNOWN AS HOLIDAY LANE

NOW, THEREFORE, BE IT ORDAINED AND ENACTED AND RESOLVED by the Council of the MUNICIPALITY OF MONROEVILLE as follows:

WHEREAS, Holiday Inn, Max n Erma, the Shaw Building, the IT Building, William Penn Associates and Springhills Suites, together with other major commercial uses have accessed to and use Holiday Lane; and

WHEREAS, the parties have placed in escrow the sum of one-half (1/2) of the costs improving Holiday Lane; and

WHEREAS, said commercial establishments have requested that the Municipality formerly accept Holiday Lane as a public street or roadway within the Municipality of Monroeville.

NOW, THEREFORE, BE IT ENACTED AND ORDAINED that the Municipality of Monroeville hereby agree as follows:

SECTION 1: The following street or portion of street, Holiday Lane, a fifty (50) foot wide right-of-way, as more fully set forth is hereby accepted by the Municipality together with the respective fifty (50) foot wide right-of-way as set forth in the plan and drawing attached hereto marked Exhibit A and made part of this street acceptance.

SECTION 2: A grade of such street or portion of street heretofore designated shall be the grade and now exists on the ground.

SECTION 3: All Ordinances or parts of Ordinances which are inconsistent herewith are hereby repealed. The following Ordinance or parts thereof are specifically repealed; and

SECTION 4. If any sentence, clause, section, or part of this Ordinance is for any reason found to be unconstitutional, illegal or invalid, such unconstitutionality, illegality, or invalidity shall not affect or impair any of the remaining provisions, sentences, clauses, sections or parts of this Ordinance. It is hereby declared as the intent of the Municipality that this Ordinance would have been adopted had such unconstitutional, illegal or invalid sentence, clause, section or part thereof not been included herein.

ORDAINED and ENACTED this 13th day of August, 2002.

ATTEST:

Marshall Bond, Manager

MUNICIPALITY OF MONROEVILLE

James J. Lomeo, Mayor

ENTERED INTO LEGAL BOOK ON: August 23, 2002

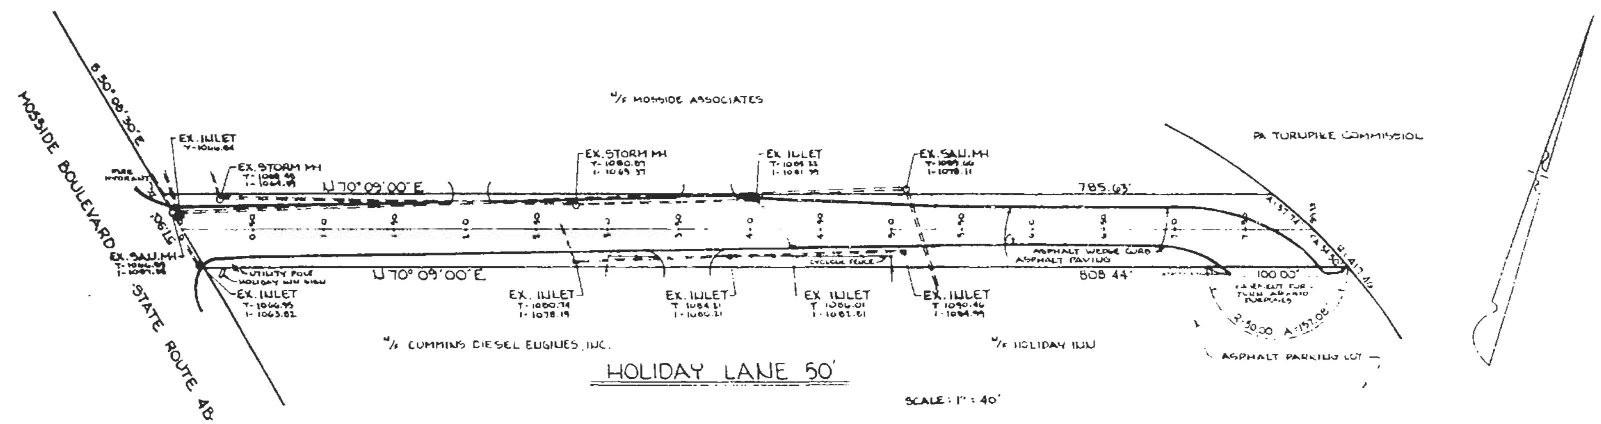

HOLIDAY LANE 50'

SCALE: 1" = 40'

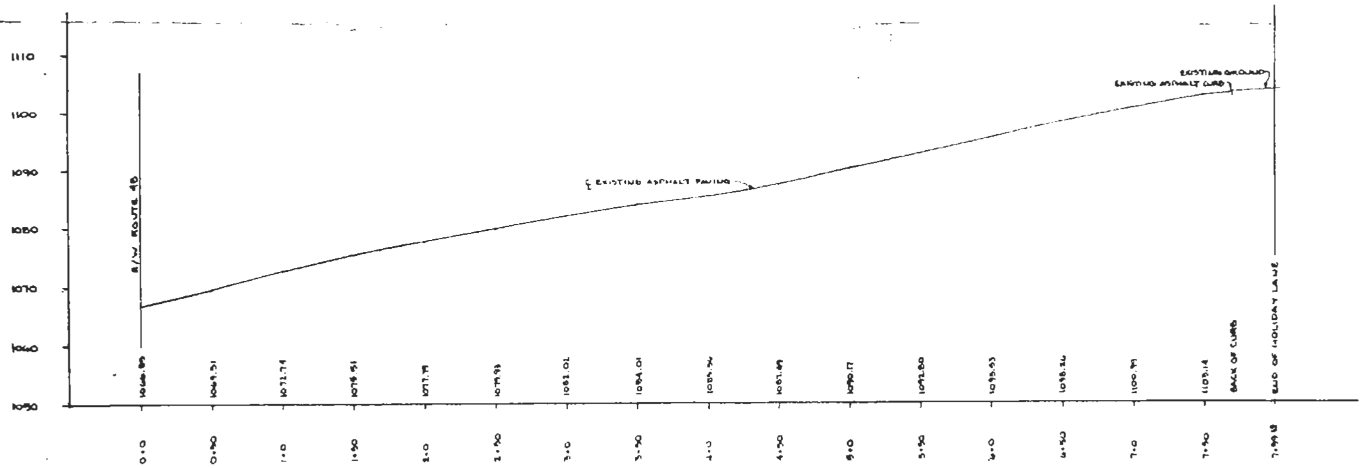

HOLIDAY LANE PROFILE

SCALE: VER. - 1" = 10'
HOR. - 1" = 40'

HOLIDAY LANE AS-BUILT

SITUATE IN:
MONROEVILLE
ALLEGHENY COUNTY, PA.

FOR:
MOSSIDE ASSOCIATES

SCALE: 1" = 40'   DATE: DECEMBER, 1986

BIERWERTH, BARTON, BURR, & ASSOC., INC.
ENGINEERS AND SURVEYORS
2000 BOLES COURT
BETHEL PARK, PA. 15102

REVISED: JANUARY 21, 1987

OR. NO. - 4884